


MC 45-A31 OLT 1980
J. LARVER
171 HOLMES

(36)

WEBER CACHE CO. LINE

SAWD LINE TO COR OF SEC. 15 16. R1 22

NICK CHUREN'S OWNER.

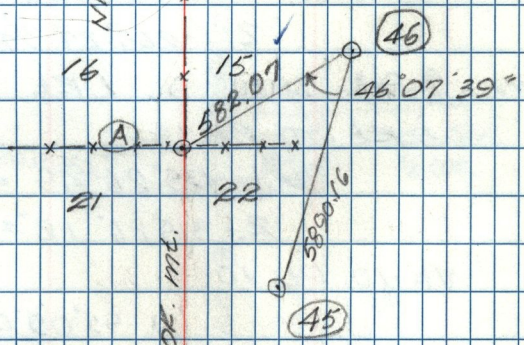

27 11.3

SWAN RANCH

FENCE COR. ME.
N.F.