


RESURVEY BETWEEN PLS. 22-23.

161° 31' 09"
161° 31' 11"
161° 31' 10" - 2d.

461.875 - 2d.

0 50.707

137° 06' 27"
137° 06' 10"
137° 06' 23" - 2d.
137° 06' 09" - 2d.
137° 06' 17" - 2d.

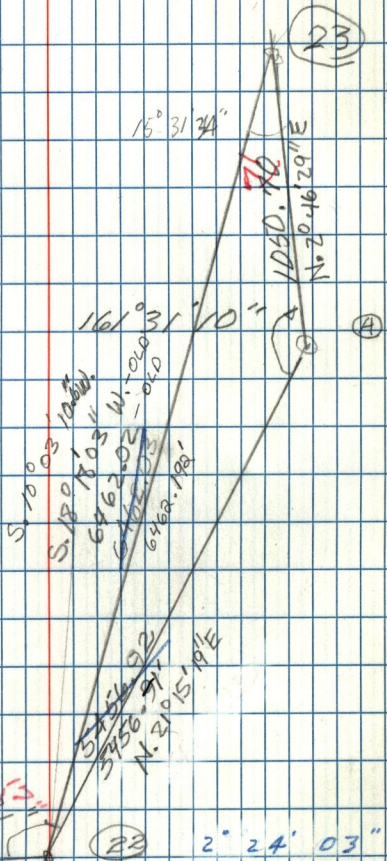

6462.02
6462.02
6462.02
6462.198 -

N. 21° 15' 19" E

(21) N. 64° 08' 58" E.
315.57

(23) 2° 24' 03"
2° 24' 07"
2° 24' 03"
~~2° 26' 33"~~
2° 24' 04" - 2d.

DISTANCES AND BEARINGS
By CLOSURE ON SHEET # BLUE.