

27 OCTOBER 77

NOTES P.W. 19,


WYLLIE T

LANSFORD R

NORTON L

NOTE:

DISTANCE FROM SEC
COR TO STA C = 2671.06'

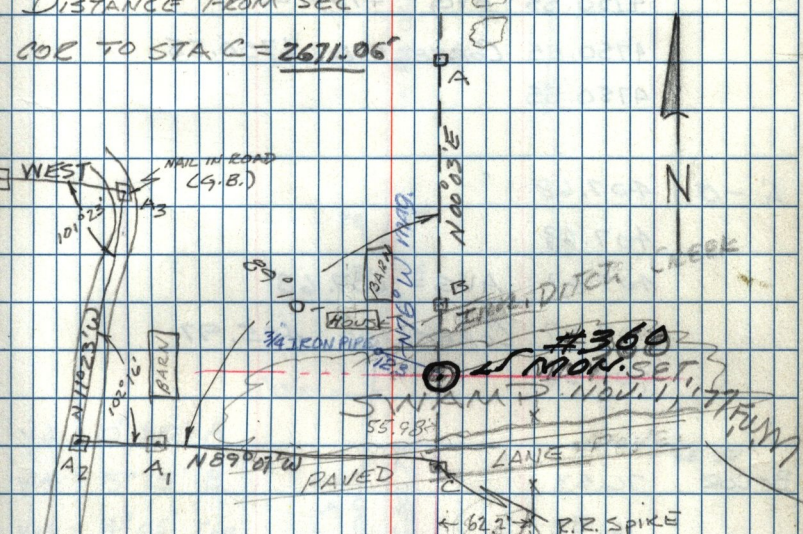

DIST A ₂ TO A ₃	232.74	DIST A ₁ TO C	647.22
	.75		647.22
VERT \angle 1°27'	.71	VERT \angle 0°19'	.23
	.69		.23
	.71		.22
	<u>232.72</u>		<u>647.22</u>
CORRECTED	232.64	CORRECTED	647.21

DIST A₁ TO A₂ - 263.62

DIST A ₃ TO WILSON PROP.	VERT \angle 0°12'	.58
		.57
VERT A 200'	445.01	.58
	445.02	
	444.99	
	445.00	
	445.01	
	445.00	
	<u>263.59</u>	
	CORRECTED	263.40

CORRECTED 444.73