MC 45-(6)

27 OCT 1977

T WYLIE

Φ LANSFORD

REFERENCE TO SECTION CORNER
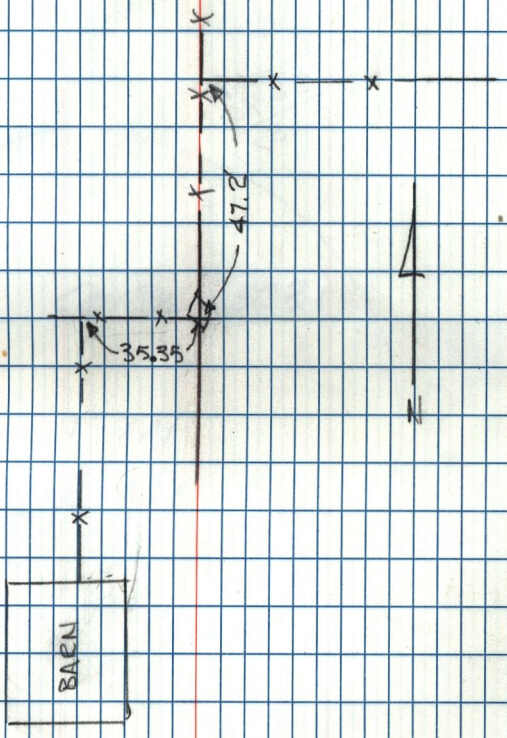
#359