
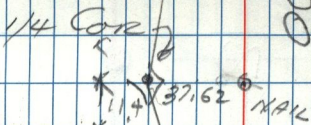


5900 E STR


N 1/4 Cor
SEC 2

2-10-79
FRED, JACK
& BLAINE

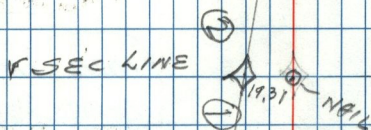

1900 N.

BRASS

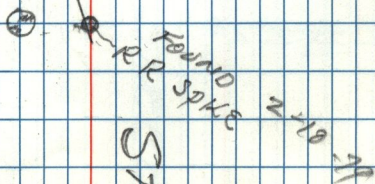

572