SEC. COR. TYE

#336

MALAN
CARVER
PARKER
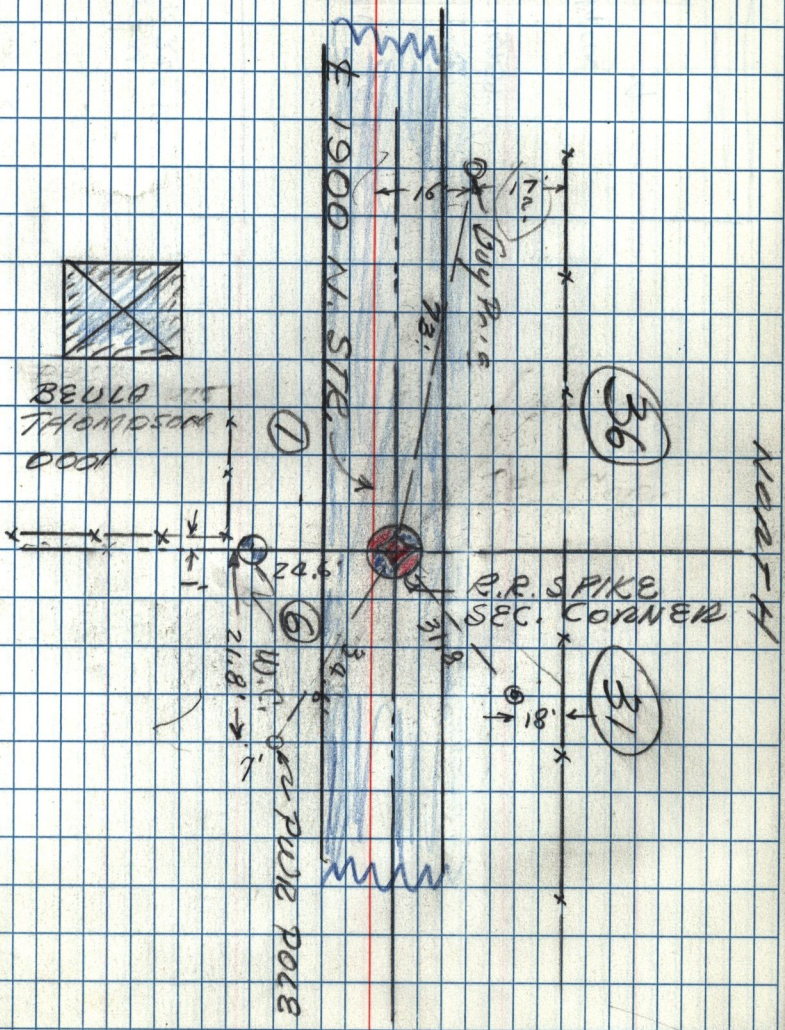
(NEAR 20-001-0001)