


CLOUDY. 50°

27 FEB 1979 - 28 FEB

FRED MALAN
JR CARVER

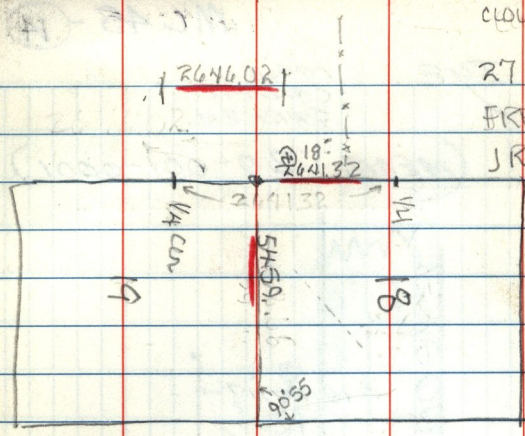

TSM
R 2 3 W