


SEC 18 TSN R2W

2726.73
2726.64
72
73

2711.63
67
54
42
66
60

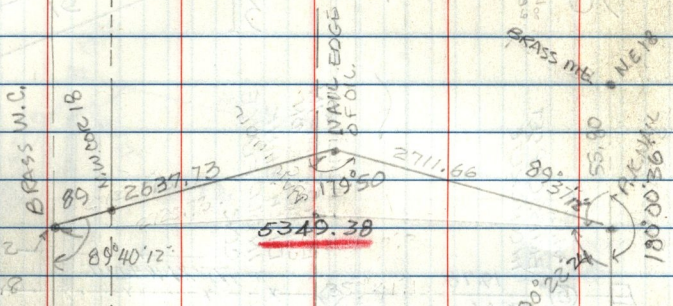

89°40'2
179°20'8

5349.38

180°00'36
90°55'2

178 20
178 23

2660.52
41

2640.52

5233.02

2655.71

Brass cap
10a5

CTR 1/8
TSN R2W
W 1/4 COR
2619.44

2652.04

5900W

5500W
178°58'

5100W
2634.46

179°58'36

S.E. 1/8