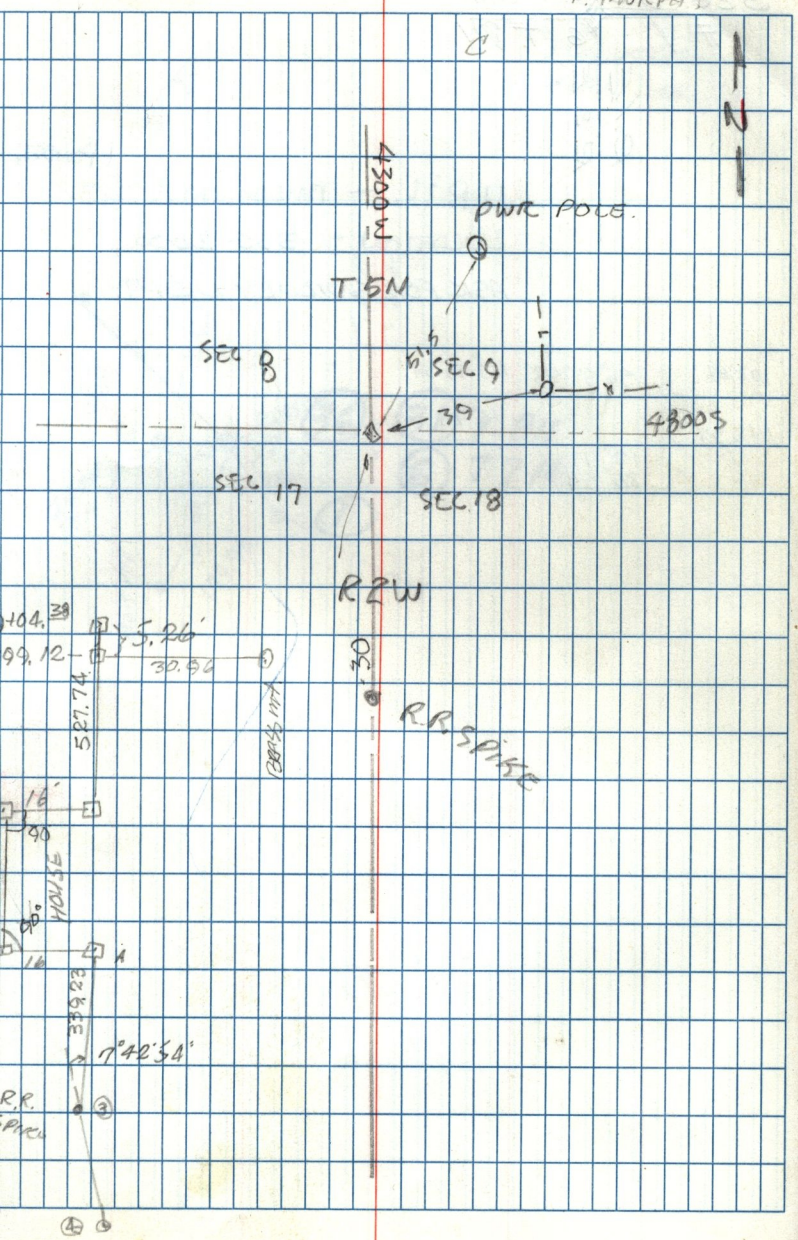MC 45- 15 AUG 79
J CARVER
B PARKER
P MURPHY
30