SURVEY BOUNDRY BETWEEN
WEBER & CACHE CO.

AUG 20 79
J. CARVER
B. PARKER

32
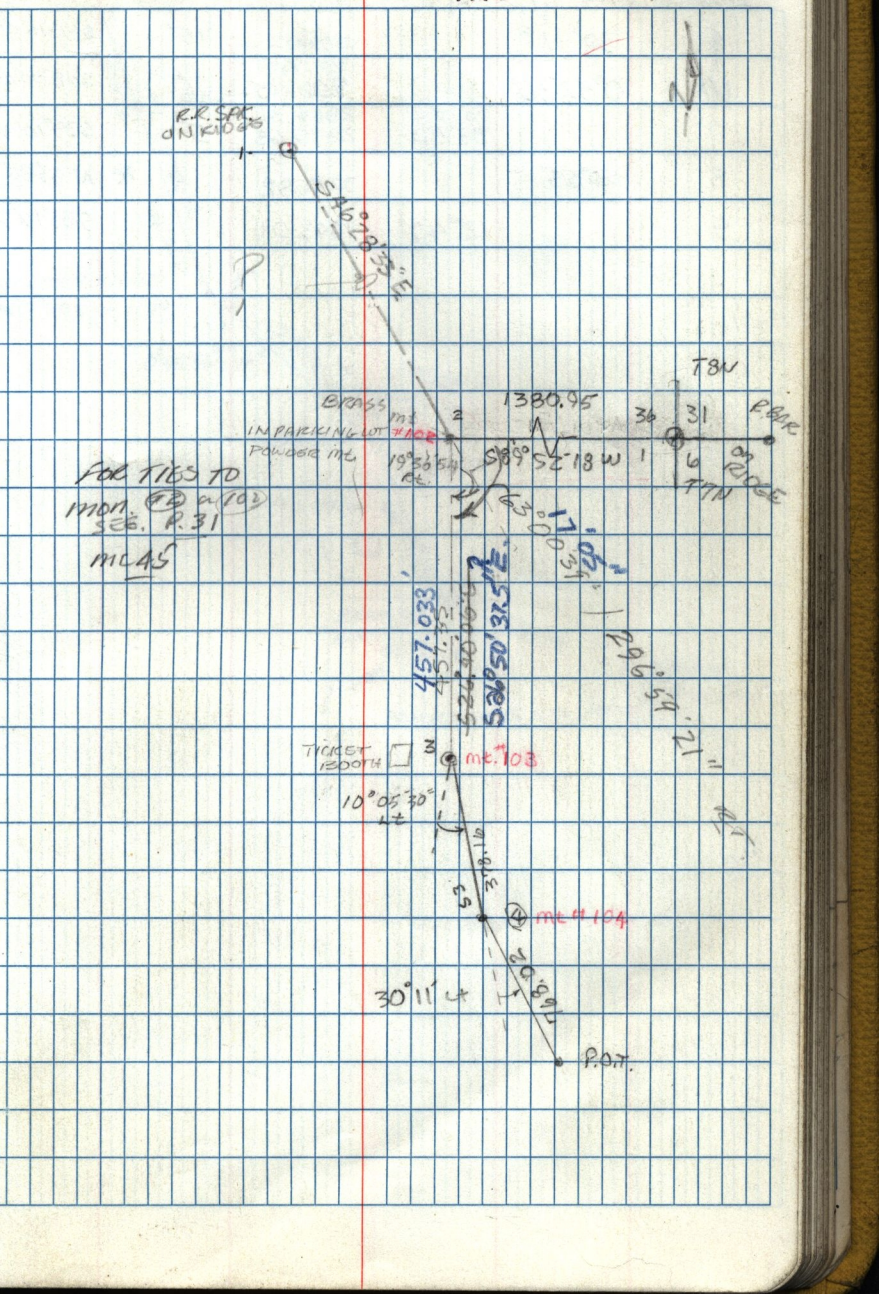
MC 15 -