


T6NR2E

MC 45- 30 DEC 79 CLEAR 40 41

CONTINUED

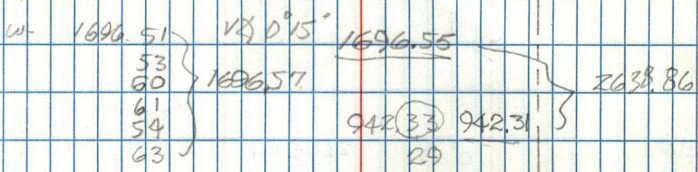


$\Delta \eta = 0^{\circ} 20'$
 $0^{\circ} 13'$

PAVED BRASS CAP 14" BELOW SURFACE

BRASS U.O. 210.79 TO 1/2 COR. 4x4 POST.

SEE PAGE 60

S 1° 31' 30" W

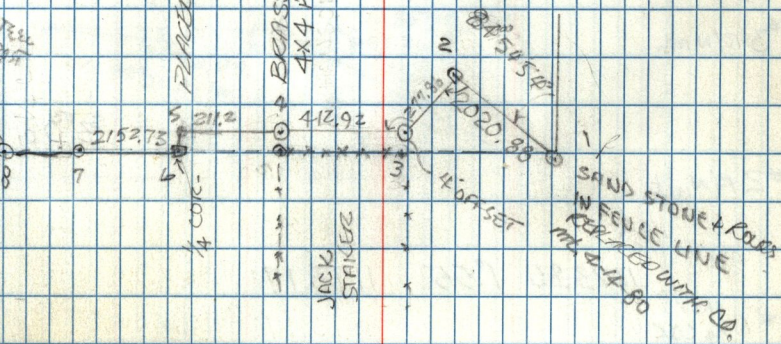

SAND STONE & ROCK
 IN FENCE LINE
 COATED WITH CO.
 M.L. 2-14-80

JACK STAINER