MC 45 – 5 MAY 1981
J. CARVER
M. HOLMES.

45
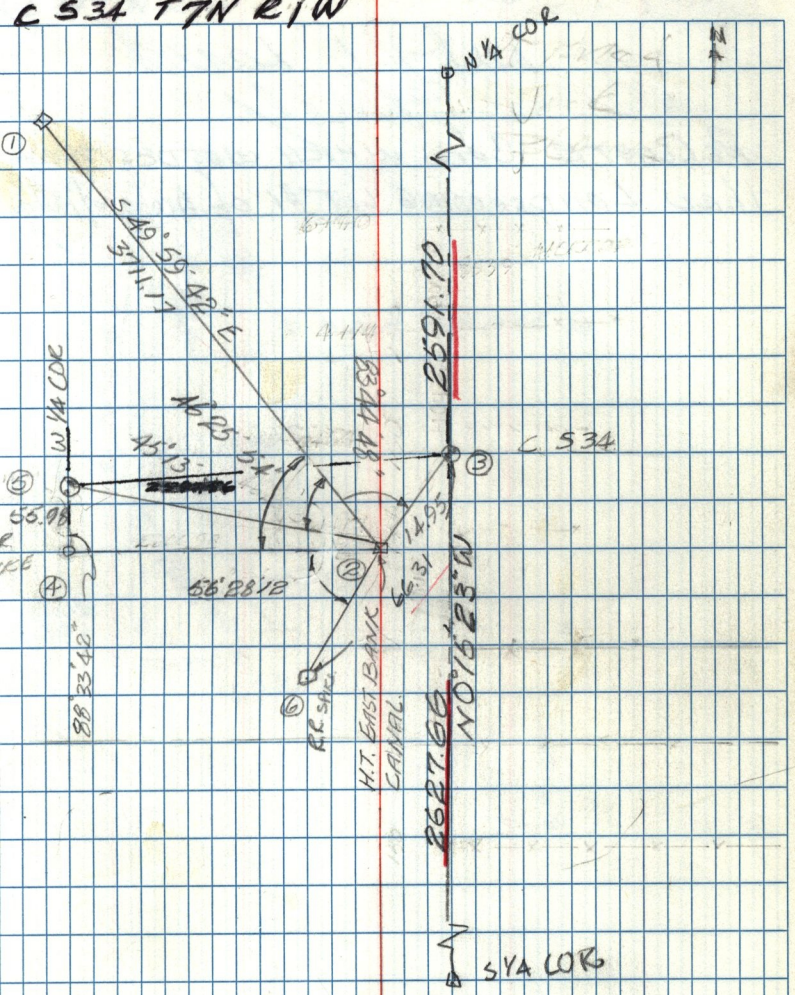
C S34 T7N R1W