
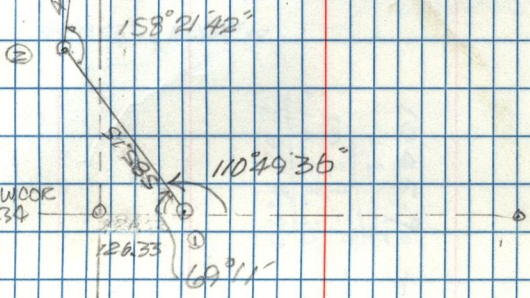


CLEAR 40°
J. CATZBERG
V. WARNER, M. HOLMES

SEC 34 T1N R1W.

N.W. COR.
SEC. 34

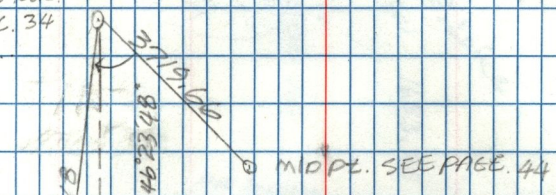

158°21'42"

110°49'36"


S. 1/4 COR.