


1/16/30

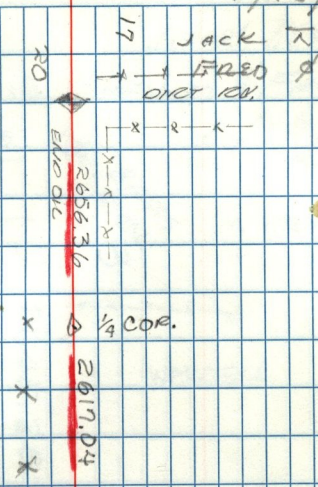

WILLIAM BOY

