


SEC. 19, 20, 29, 30 T 6 N R 2 W


2626.70 2637.00

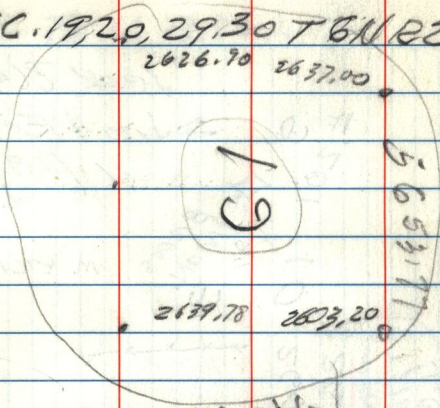

2627.63 W
 2651.00 E
 5278.63
 2639.03
 2634.26
 51.05
 16.74
 10.69

2 1.61
 .93
 76

2646.75 2680.75

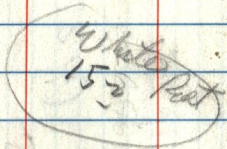


17.65
 16.45
 22005
 51000



2659.70


2655.00

5656.24
 1.74
 2655.6

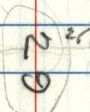

2661.89

19 20
 30 25
 25.1

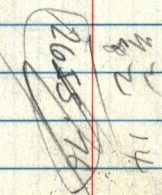

2655.74

20 21
 29 28

14