MC 45-55
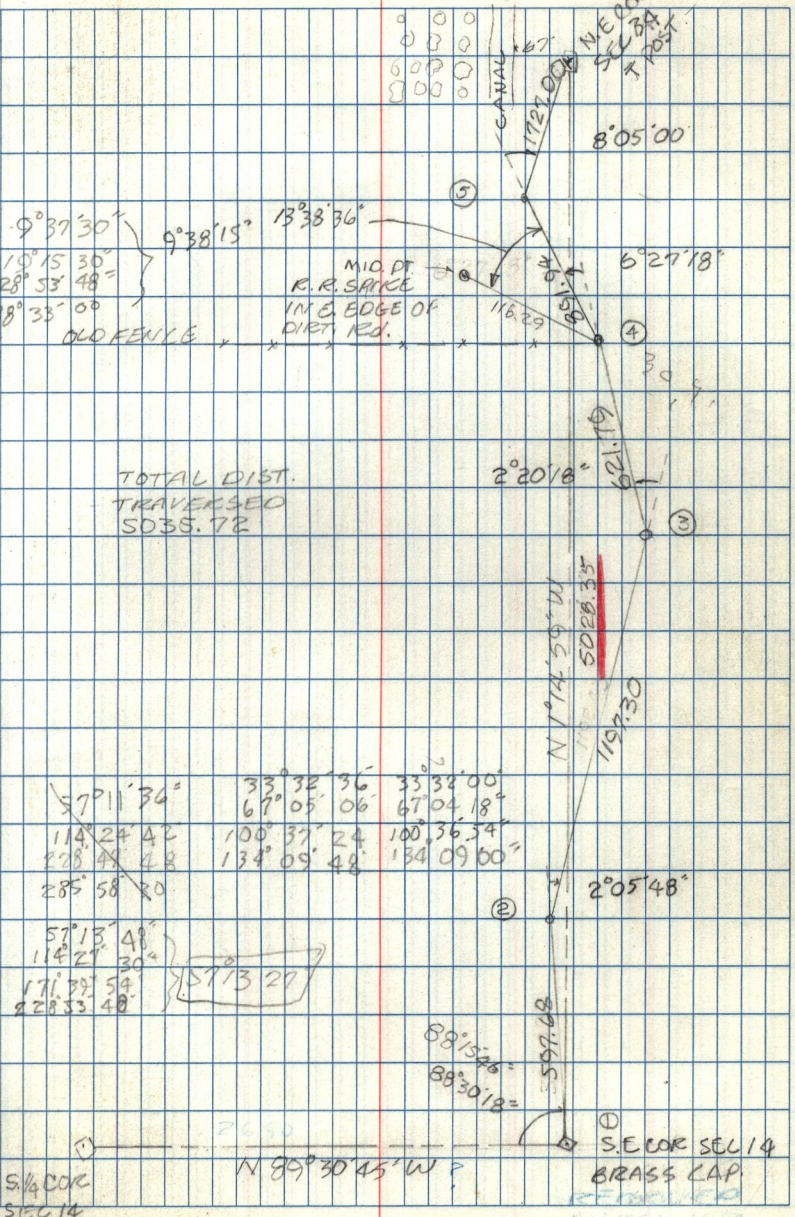
T7NR2W. SEC 14