


JACK, 4/4/80
MIKE
FRED
(SUNNY DAY)

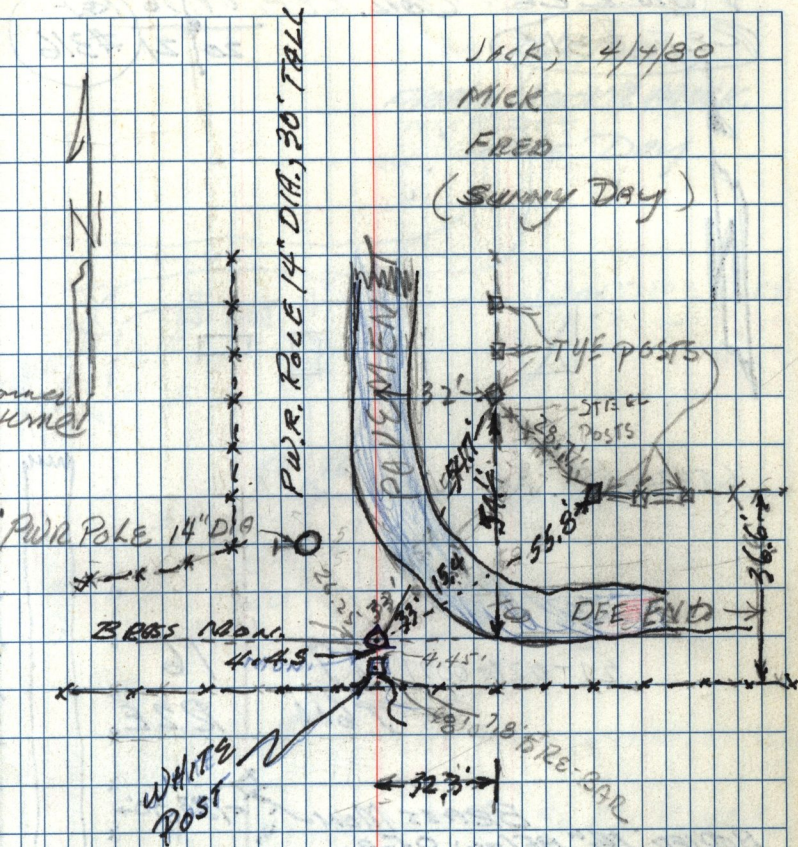

SET NOON 4/4/80

48.4
32