


MC 45-15 APR 1980

JACK  
FRED

T6N R2E SEC 6

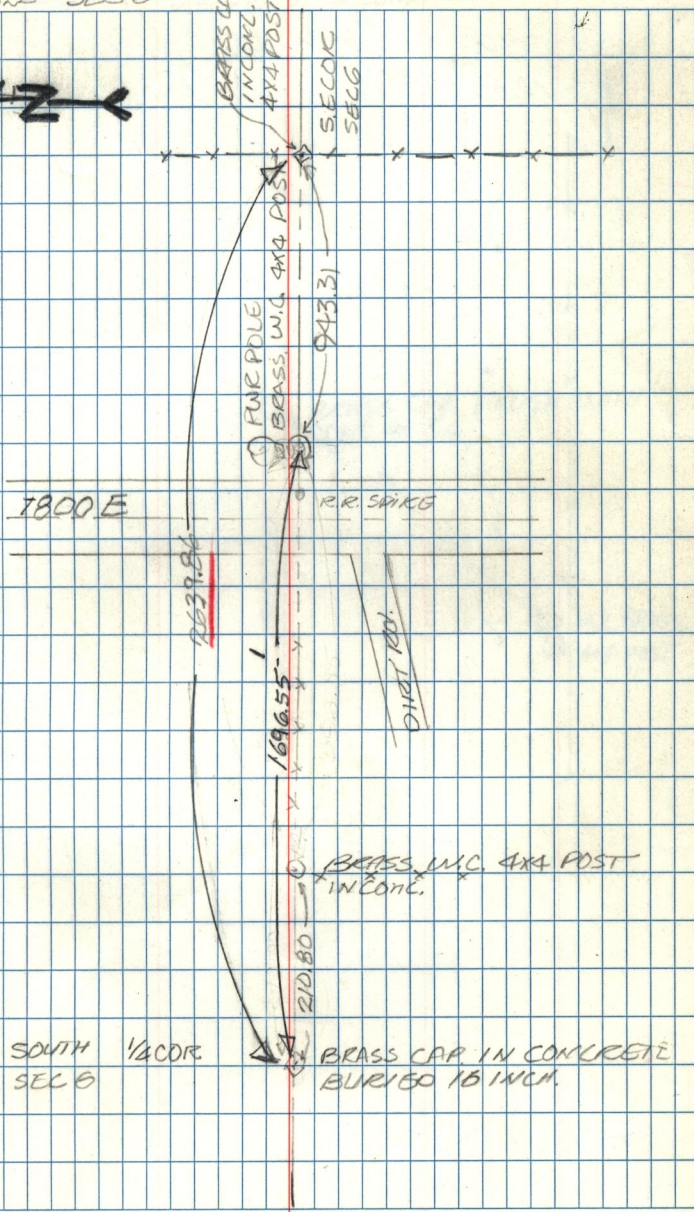

BRASS CAP.  
IN CONCRETE  
4X4 POST.

SEC 6  
SEC 6

FUR POLE  
BRASS W.C. 4X4 POST.

943.31

1800 E

RR. SPIKE

2639.84

DIRT RD.

1690.55

210.80

BRASS W.C. 4X4 POST  
IN CONCRETE

SOUTH 1/4 COR  
SEC 6

BRASS CAP. IN CONCRETE  
BURY 16 INCH.