MC 45-73

12-3-80

VERN & FRED
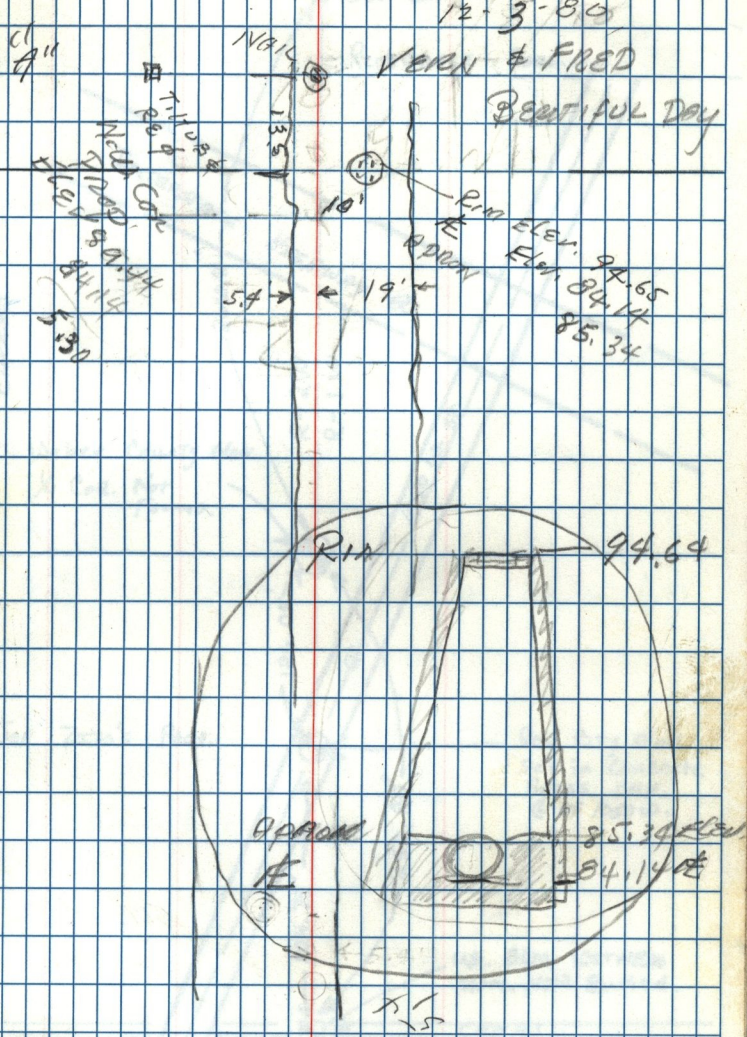
BEAUTIFUL DAY