

FEB. 5, 1980


FRED MALAN  
BLAENE PARKER.

SECTION CORNER

Common TO Sec's

23, 24, 25, 26

T. 6 N. - R. 2 W.

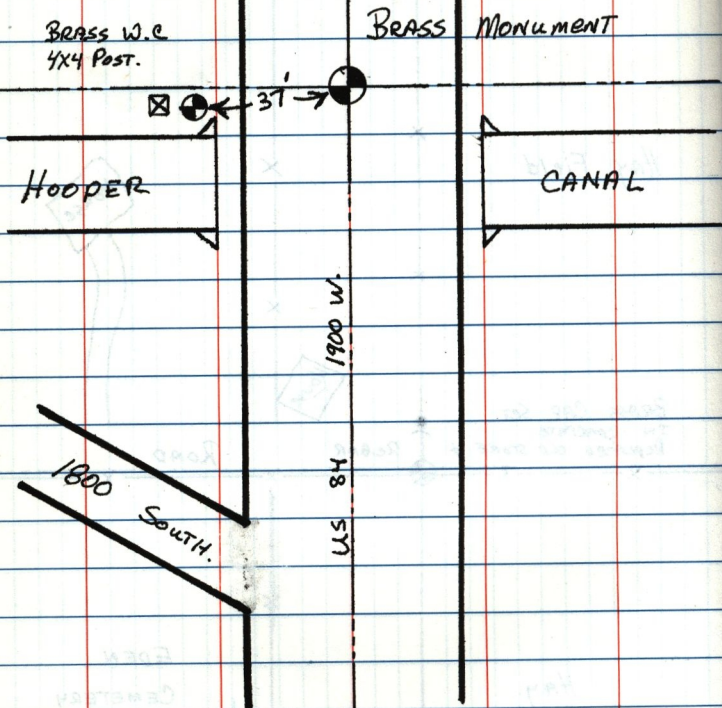

Replaced R.R. spike with County monument  
Brass cap set in concrete.  
Witness same type monument located 37'  
West of Monument.