


SEPT. 11, 1980

J. CARVER
M. HOLMES.

MC 45-77

1/4 CORNER COMMON TO SEC. 19+20 T.7N. R.1W.

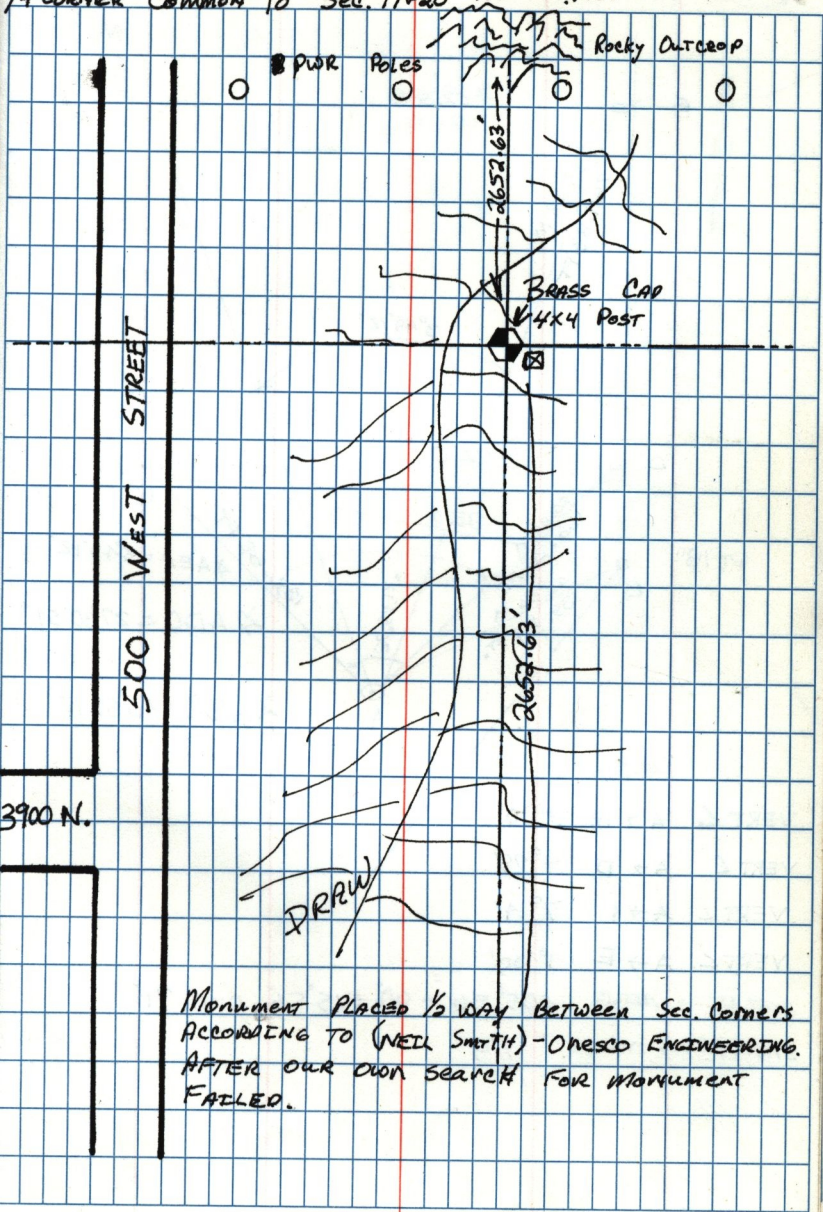

MONUMENT PLACED 1/2 WAY BETWEEN SEC. CORNERS
ACCORDING TO (NEIL SMITH) - ONESCO ENGINEERING.
AFTER OUR OWN SEARCH FOR MONUMENT
FAILED.