


RECORD - DATA

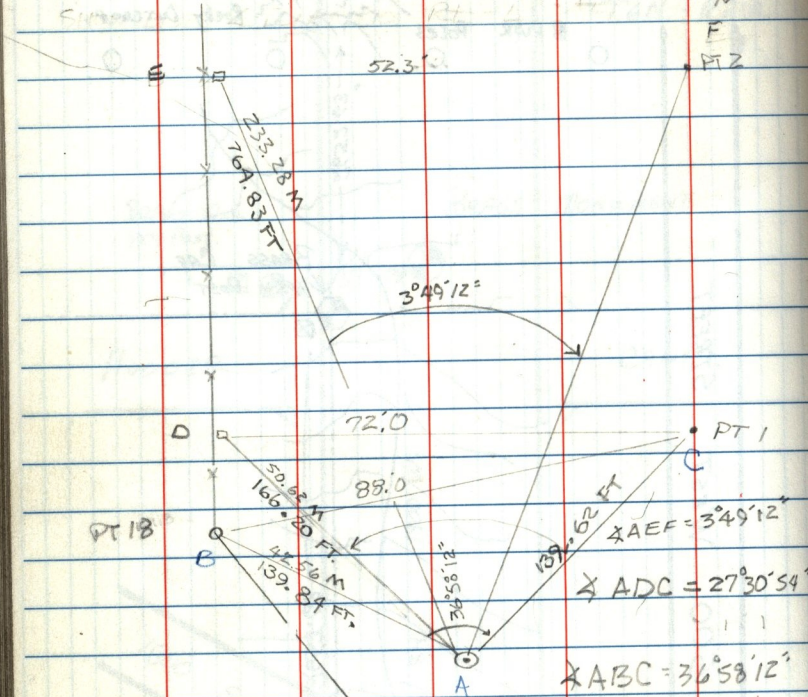

42.56

- VERT \angle A \rightarrow B $5^{\circ}10'$
- VERT \angle A \rightarrow D $4^{\circ}29'$
- VERT \angle A \rightarrow I $7^{\circ}14'$
- VERT \angle A \rightarrow E $1^{\circ}00'$

INST. PT \rightarrow MOUNT 105°56' - 90° = 15°56' DIST 71'

INST. PT \rightarrow mt. pt 1°9'

START