


LARSON, JOSEPH W.

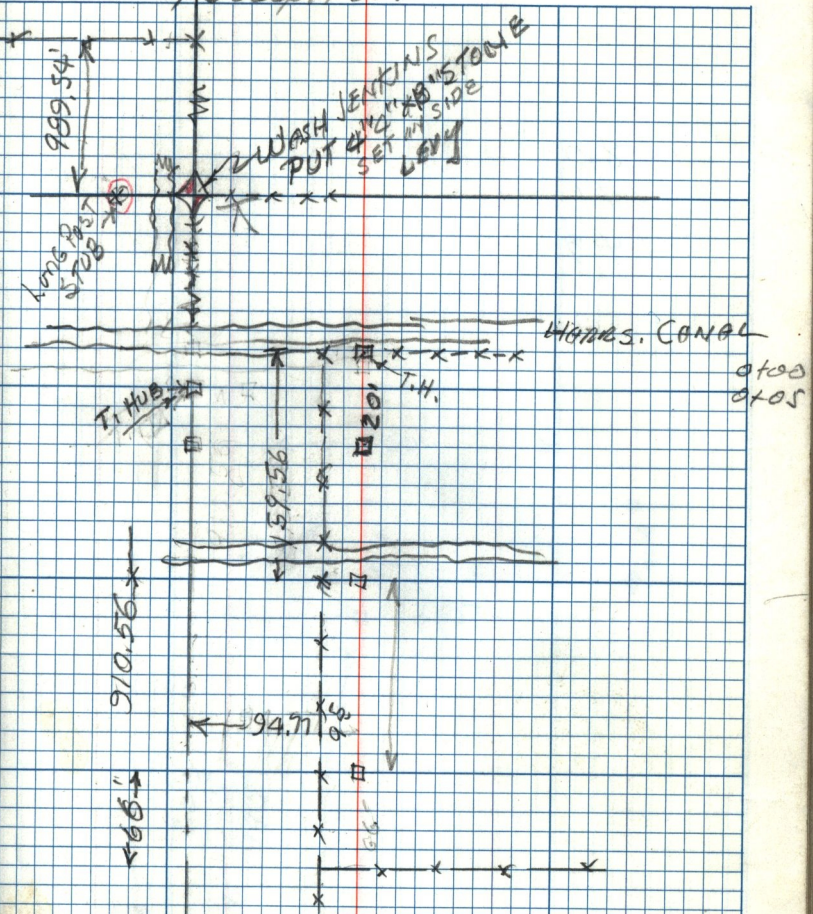

Cont. on Pg 44