INCINERATOR (OGDEN UTAH

30'X30' UNSHREDED GARBAGE
WEST PILE
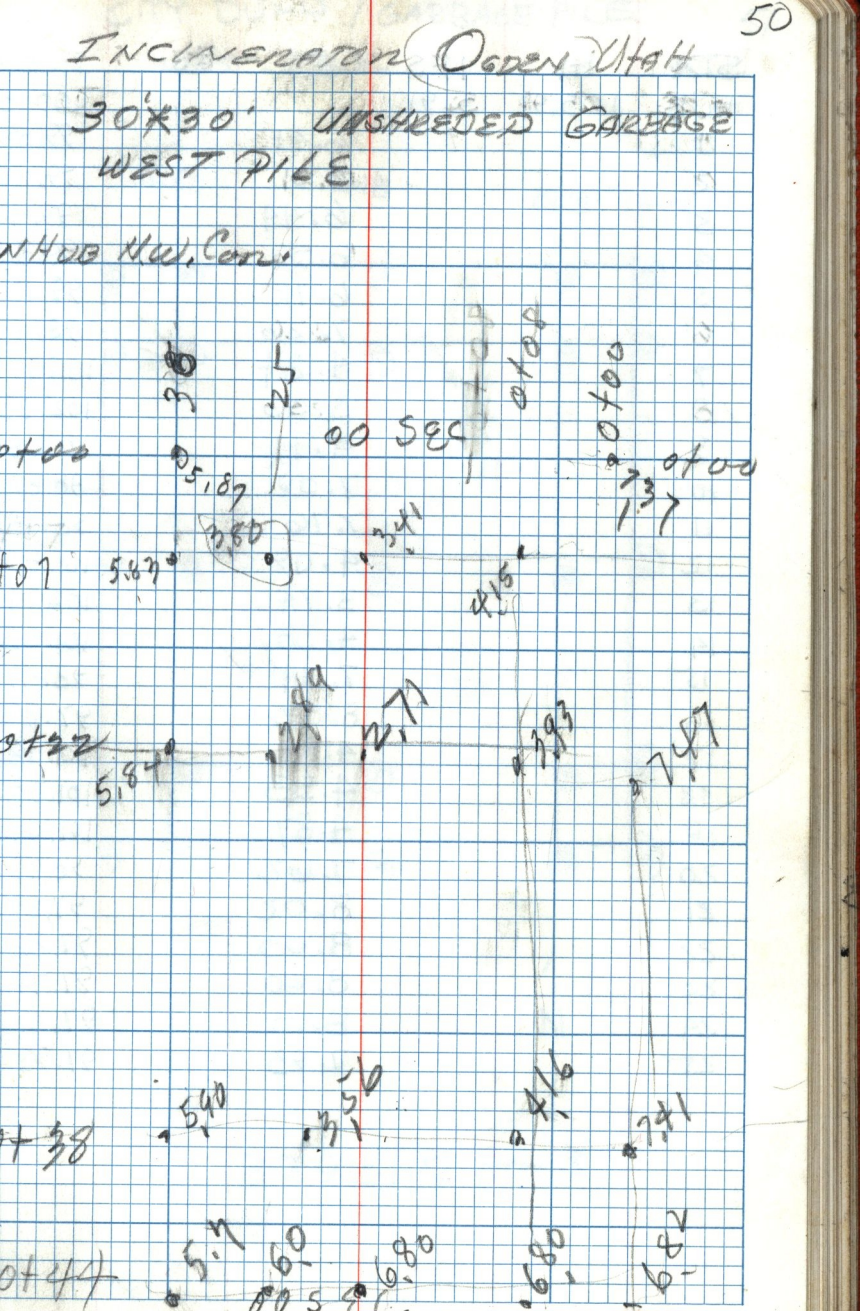
NHub Nw. Corn.