
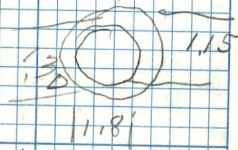


OUT 94.29  
1.95  
 o/o HUB 92.34

118

0.32 FROM  
 TOP DRUM

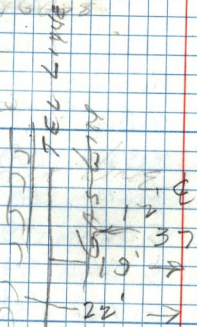

3.86

7.86  
6.23  
 1.63

~~3.20~~  
37

8  
25  
 190

91.43  
 92.58  
 94.30  
91.40  
 2.90

1.781  
~~1.57~~  
5.441

1.54

1.781  
1.781  
 3.66

37  
~~37~~  
 1.781