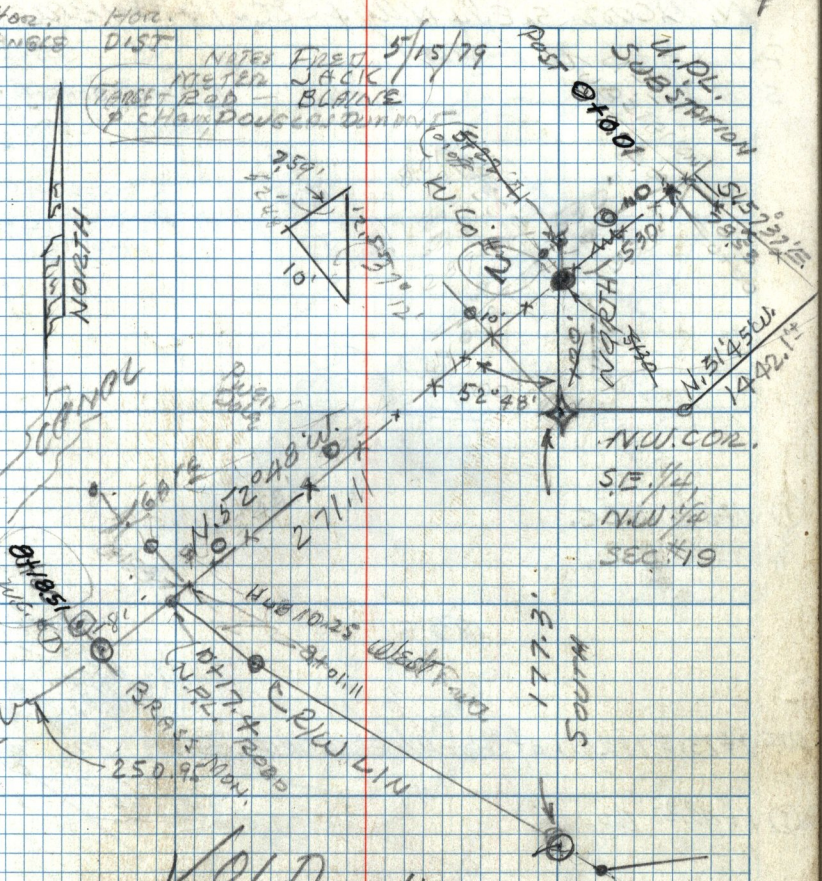

VOID
See Page #8

818.52
801.1
17.40
18.80
1.40

801.11
530.0
271.11

818.52
530
288.52
148
98

801.11
18.80
819.91
801.11