


5/22/79
Doug Fred

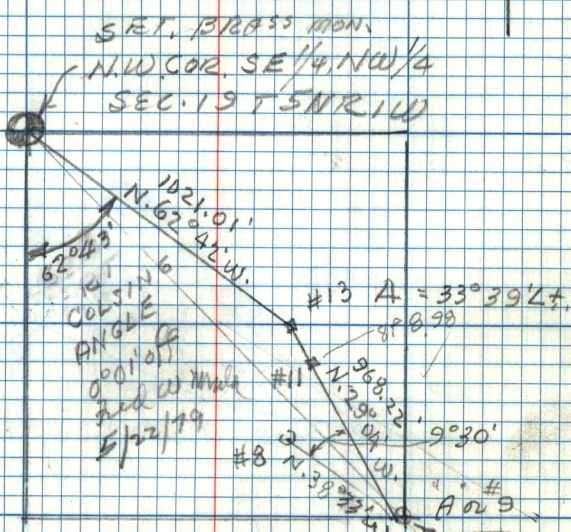

SE. COR. NW 1/4 SEC. 19
T5N R1W.

3473
930
24003
32039
N 62° 42' W