



AL. P.I. R. 2. SHINE SET IN DIAGONAL
4" BELOW SURFACE

18 JULY 79
K. I. CARVER
Q. B. PARKER
E. D. DURBAN


18

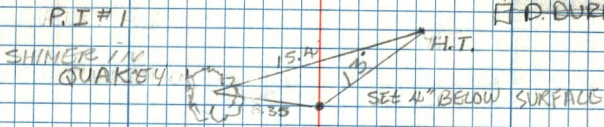

P.I. #2

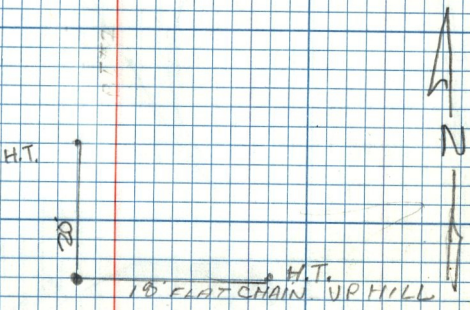

P.I. #3

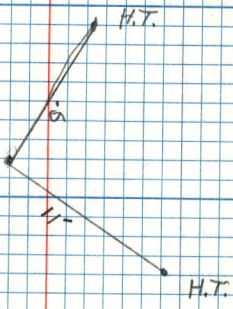

P.I. #4

