


15 JULY 79
J. CARVER
R. PARKER

OSMAND DR.

P. MURPHY

P.I. # B

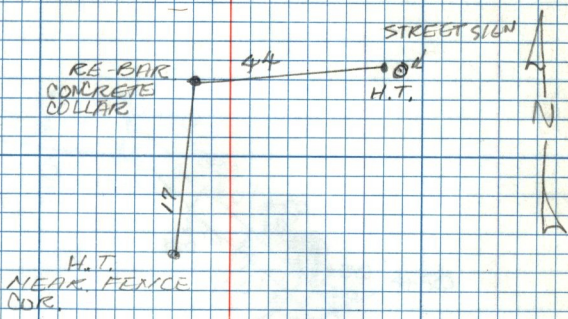

R.R. SPIKE
TOP OF HILL ON LINE
2800 W.