


Osmond Dr

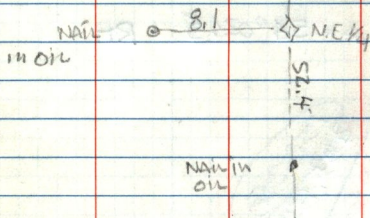

275.05.5
 180.00
 95.05

VA 275 11 = 5° 11'
 180 5 15
 95 84° 37'

90
 84° 48'
 89° 60'
 5 11
 84° 49'

91° 13' 48"
 182° 27' 36"
 275° 41.8"

1° 48'