


OSMOND DR

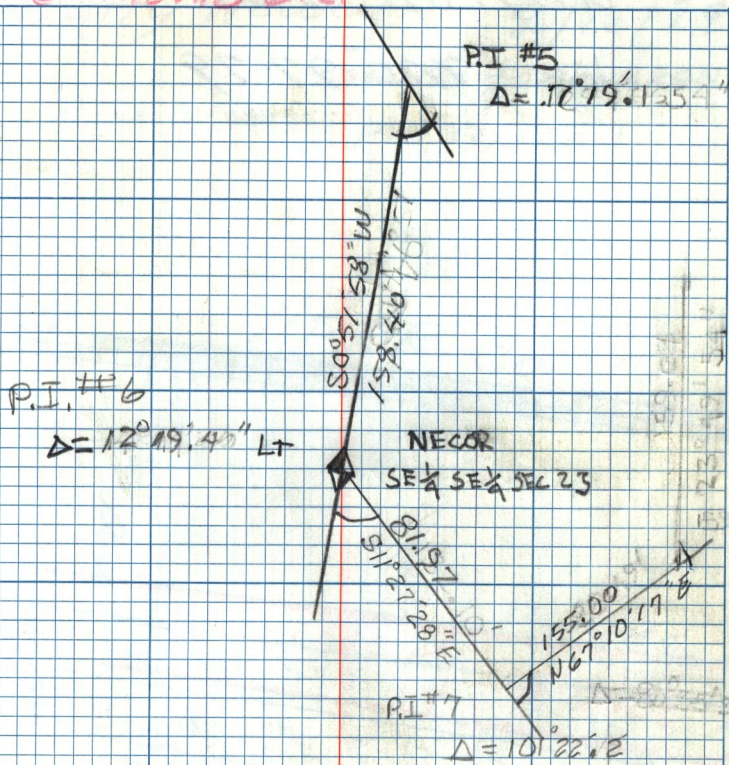

SEE PAGE 26