


U.P.R.R. LEASE TO WEBER Co. M.C. 48, 32

of ATTY NEWBY 8/16/79

DOUGLAS DURRANT
FURNALON

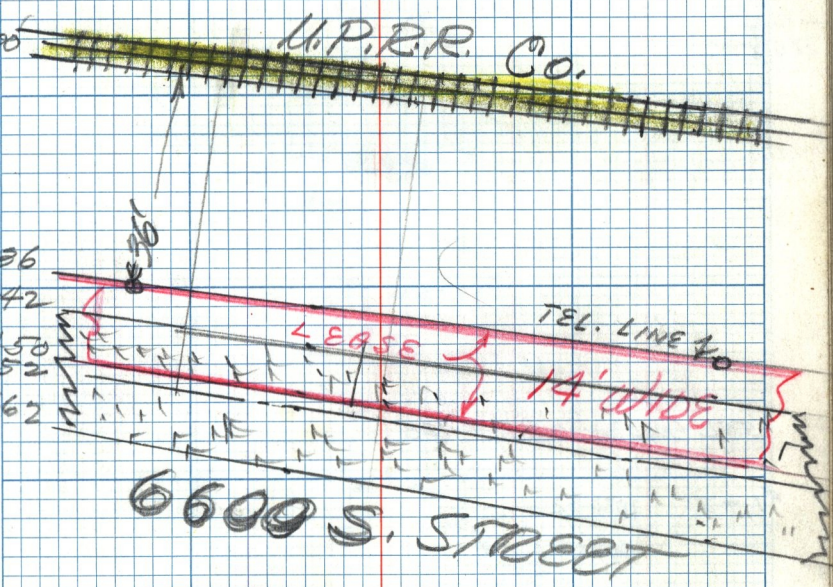

House
2057E