


(fine weather)

5-1-80
JACK, FRED & MICK,
& FRED WEAATHER

MEET ED WOODS AGENT
VTAIL STATE

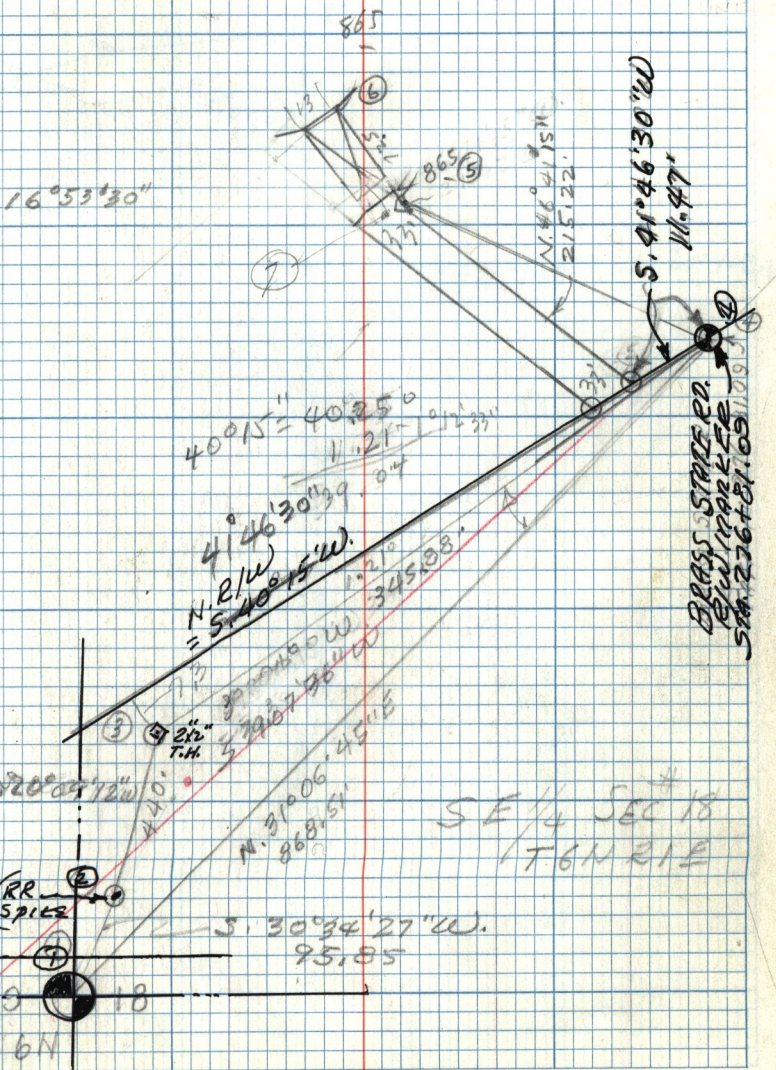

over