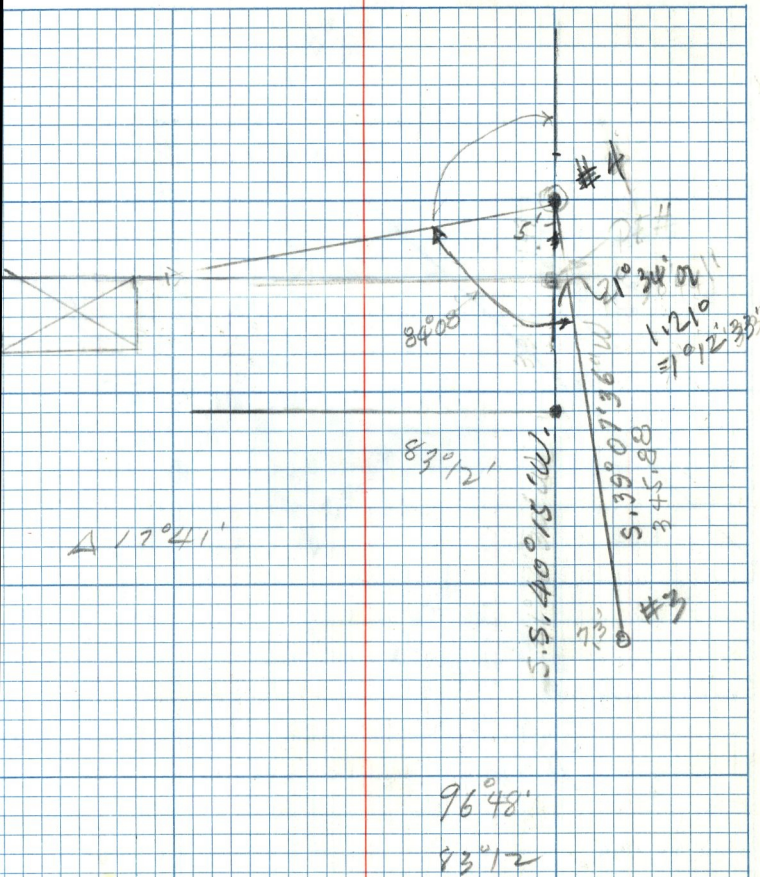
#4
5'
21°34'02"
1.21°
=1°12'33"
84°08'
83°12'
S.39°07'36"W
345.88
S.S.40°15'W.
#3
7.3'
Δ 17°41'
96°48'
83°12