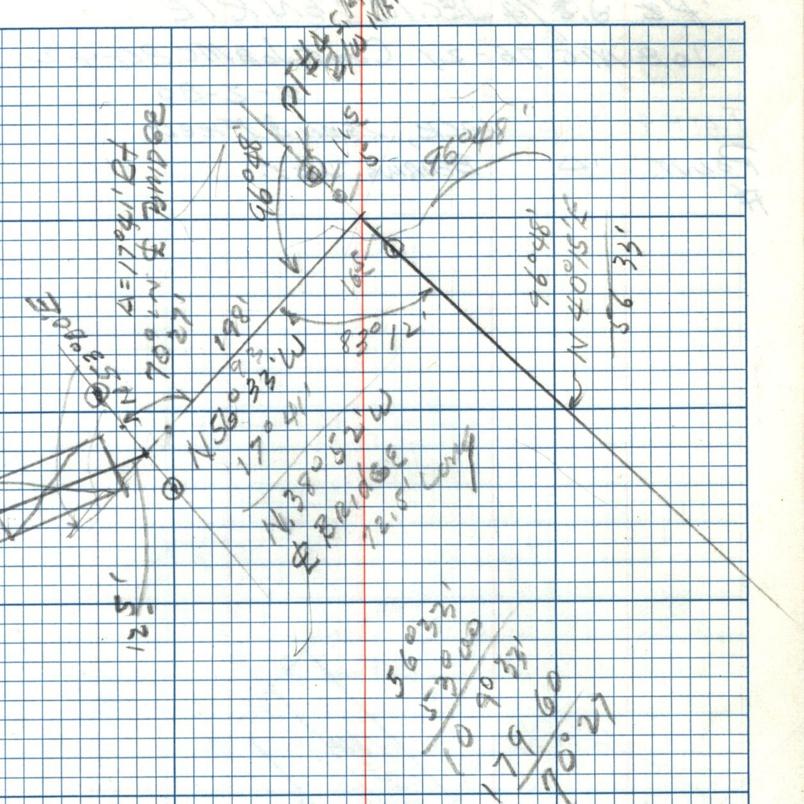

Δ=17°41' Rt
℄ BRIDGE
N 70°21'
N56°33'W
198'
17°41'
N38°52'W
℄ BRIDGE
72.5' Long
83°12'
165'
96°48'
N40°15'E
56°33'
70°21'