
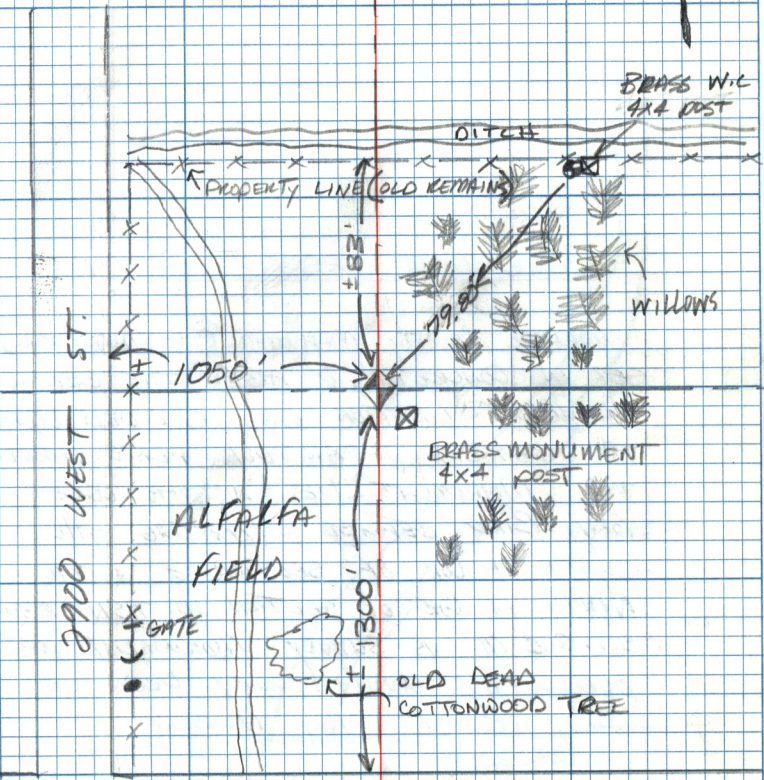


TEN ROW

14.4 '81

#408

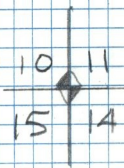

2900 WEST ST.

ALFALFA FIELD

GATE

OLD DEAD COTTONWOOD TREE

200 SOUTH ST.