


T7N R1W & R1E

# 414

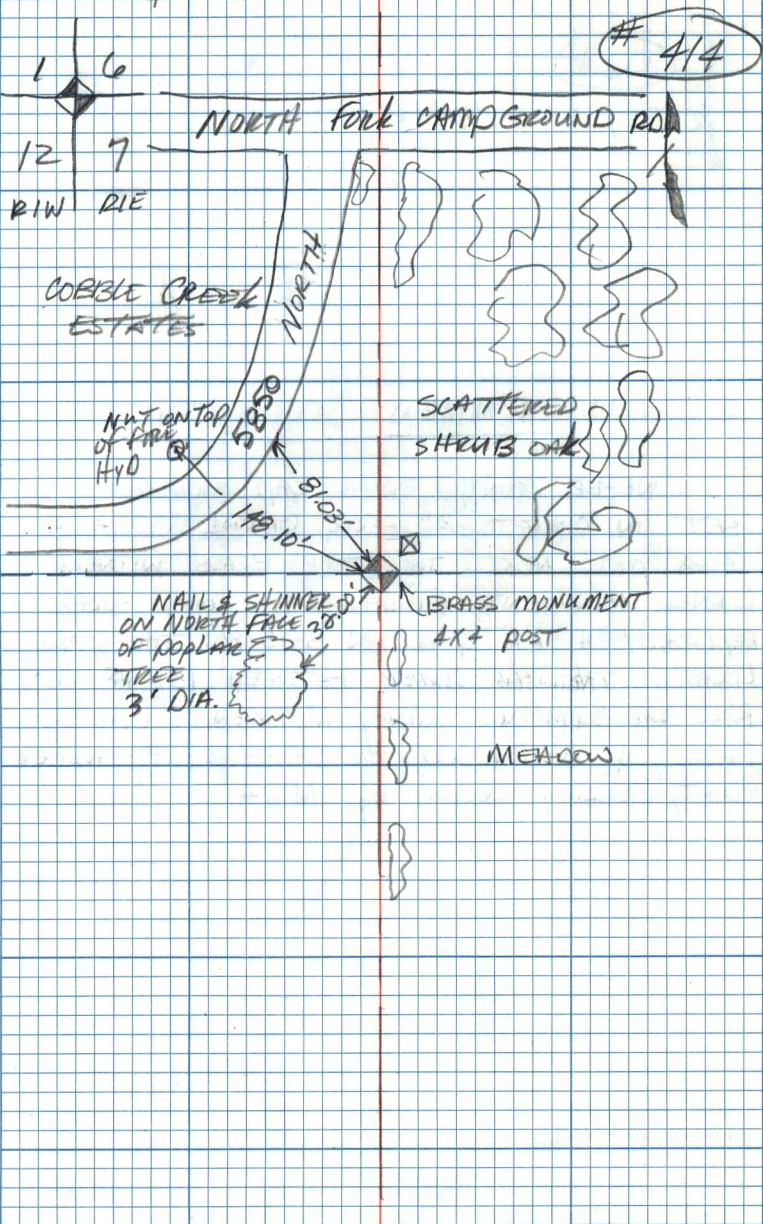

NORTH Fork Campground Road


SCATTERED SHRUB OAK


NAIL & SHINER ON NORTH FACE 35' OF POPLAR TREE 3' DIA.

BRASS MONUMENT 4x4 POST

MEADOW