

HILLIER
Holmes

NORTH FORK Rd.
Alignment

MC-49-56


July 26 '82

$$189.06' - 14.06' \\ = 175.00'$$

$$T = 150.00'$$



1/4
36
01
1/4
?
1

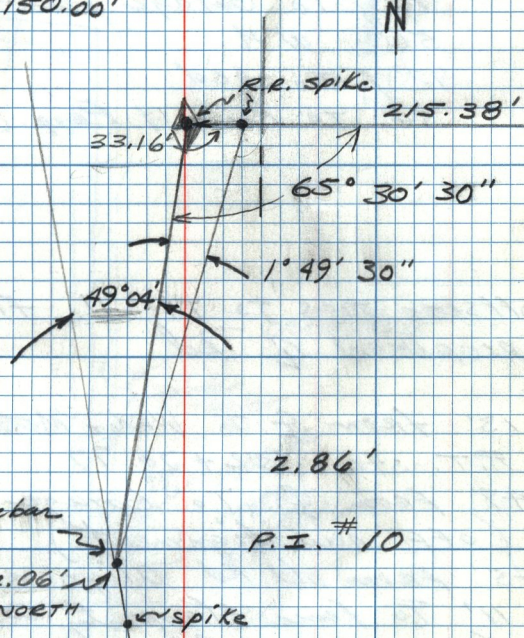

$$T = 150.00'$$

$$49.04' + 14.06' \\ = 63.10'$$