


T.O.N. R.I.W. NORTH FORK Rd.
alignment MC-48-57

DUCK CREEK
SIGN

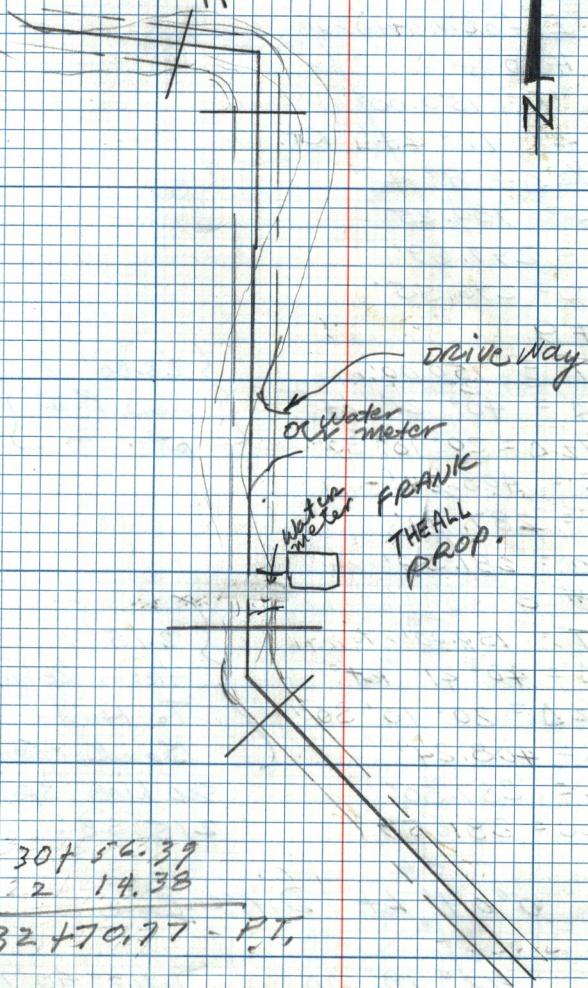

30 + 54.39
2 14.38

32 + 70.77 - PT.