F.W. MALAN
M.R. HOLMES

SPRING MOUNTAIN

AUG 18, 1982

CLEAR
95°

63

T7N R1E SEC. 19 & 30

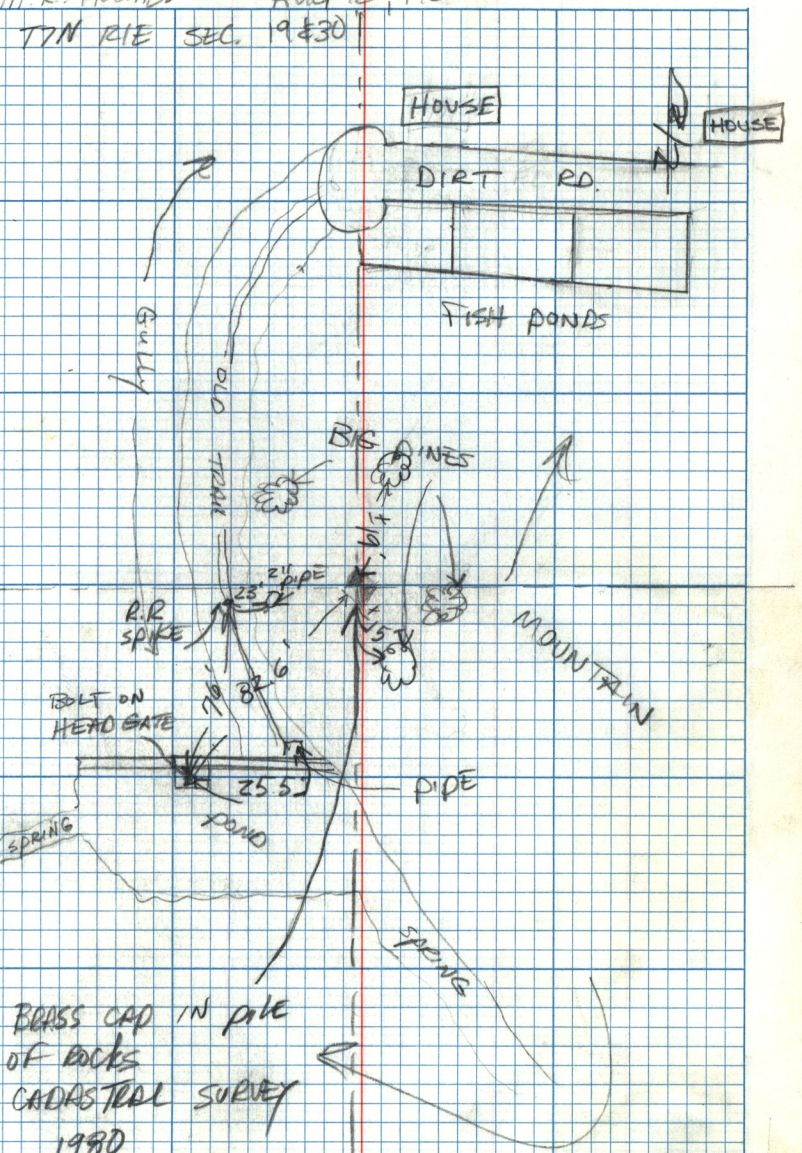

BRASS CAP IN pile OF ROCKS CADASTRAL SURVEY 1980