

(STERLING FULLER-WEBER Co) MC49(3)



Job MC65-79

6-27-79

JEFF, PHIL
F.W.M.



SERIAL #
8-96-0002

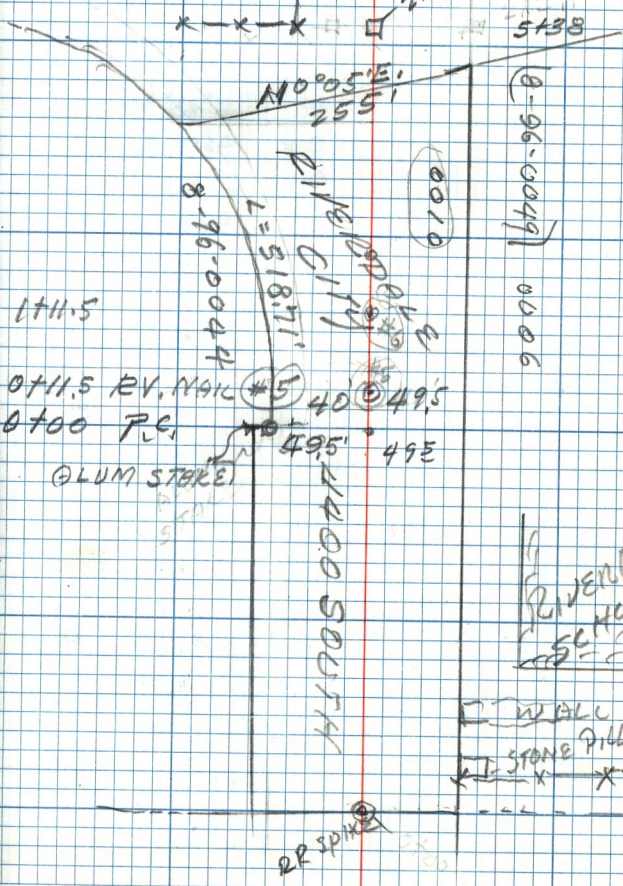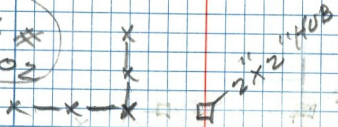

5138

N0°05'E
255'

8-96-0049

0010

0006

111.5

0111.5 EV. NAIL #5

40

49.5



0100 P.C.

49.5

49E

(LUM STORE)

4400 SOUTH

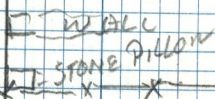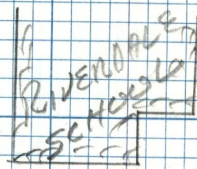

RR SPK