
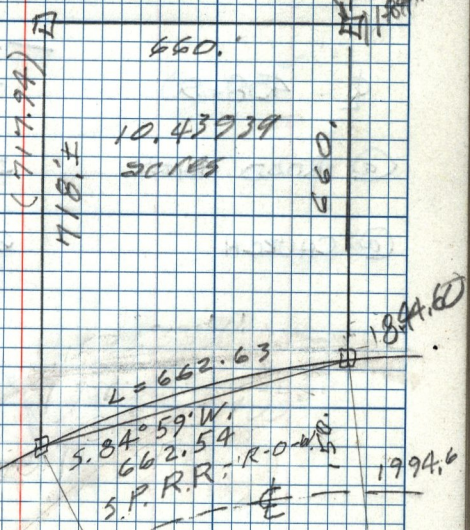


2016.
 -150.
 1866.
 -660.
 SURVEYED BY L.F. WINE & G.G.

1206. = Plat call
 1184.6 = Field call

21.4 = Diff.
 11459.2
 150.
 11609.2 = R
 $\Delta = 3^{\circ}16'13''$
 $L = 662.63$
 S. $84^{\circ}59'$ W. - Field

90°
 $84^{\circ}59'$
5°01'
 $\tan 5^{\circ}01' = \frac{x}{660}$
 $x = 57.94$
660.
 717.94

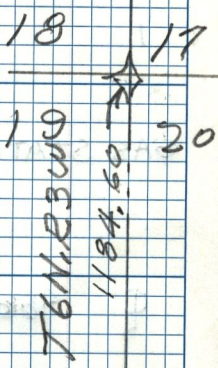

10-040-0007