


16 JAN 81
J CARVER
171 HOLMES
D. HAWKES.

5500 S. Q. TIES TO SEL COR.

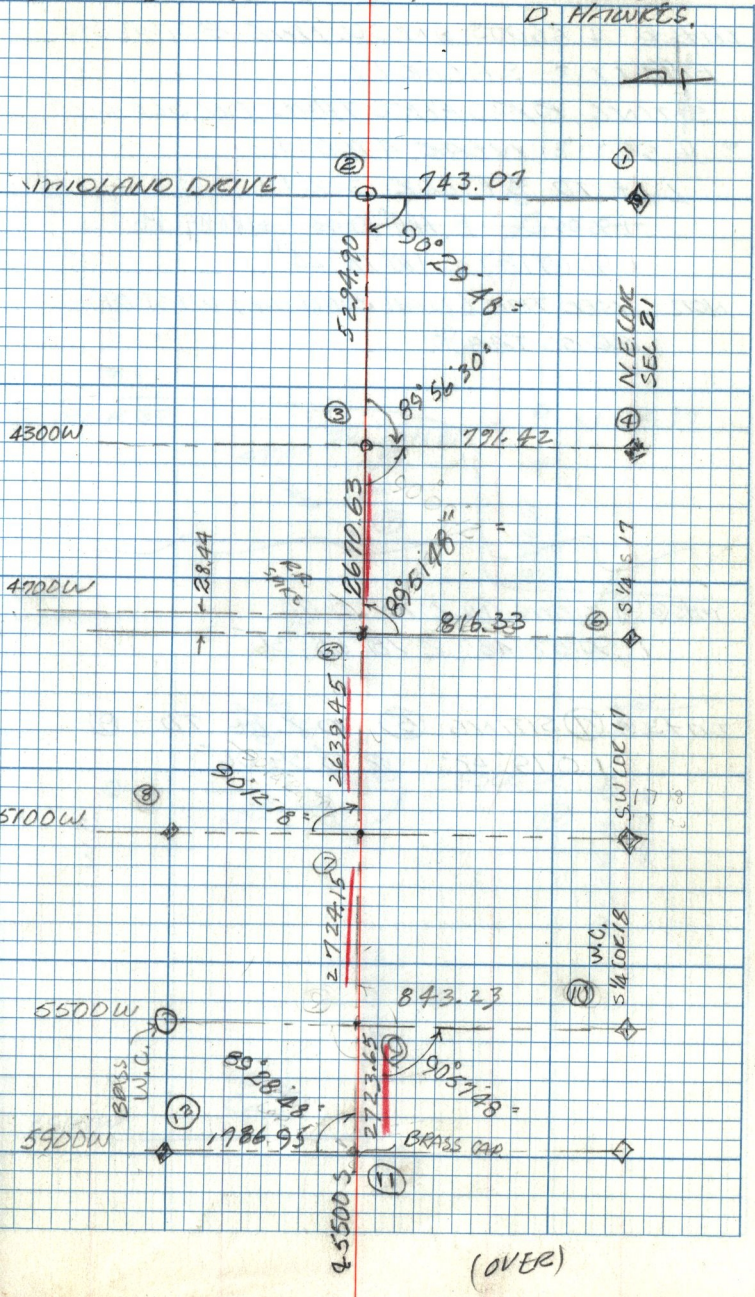

(OVER)