


T6N R3W

12 MAR 81
J. CARVER
D. HAWKES
C. CARVER

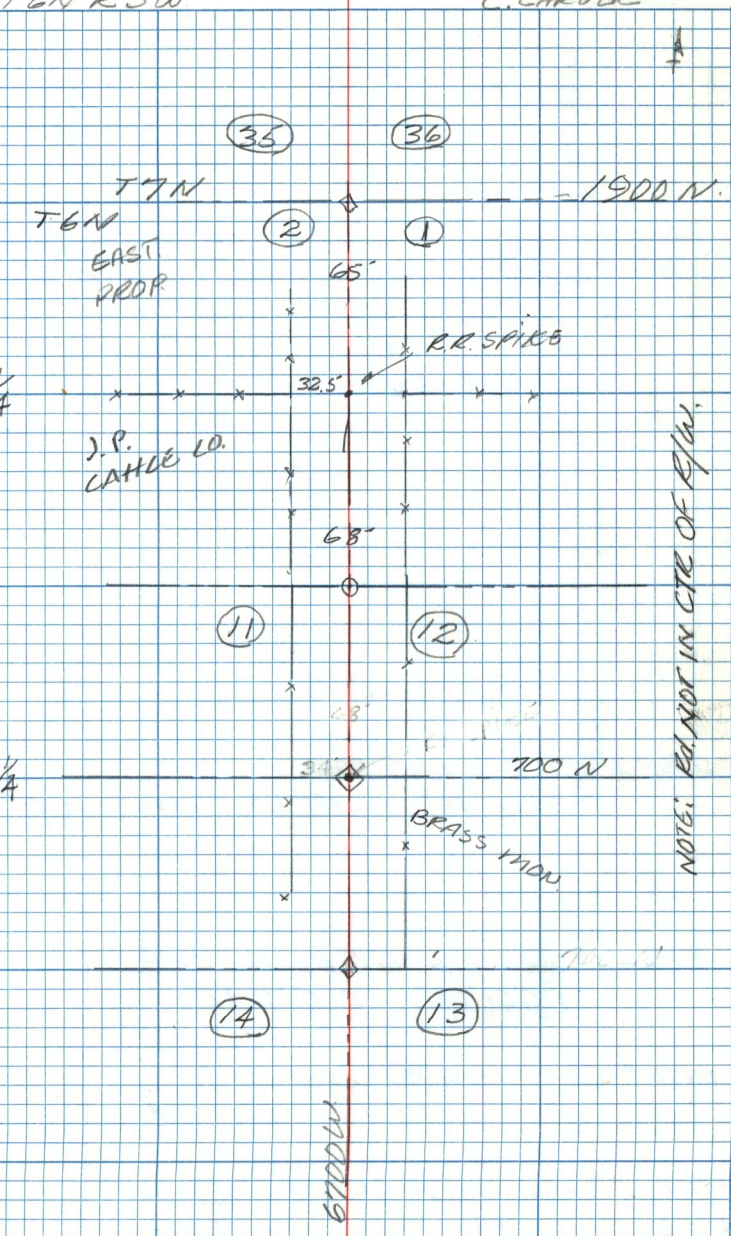

NOTE: ED. NOT IN CTR OF E/W.