


26 MAR 81

51

TRAVERSE 6300 W - FROM 4600 S N.

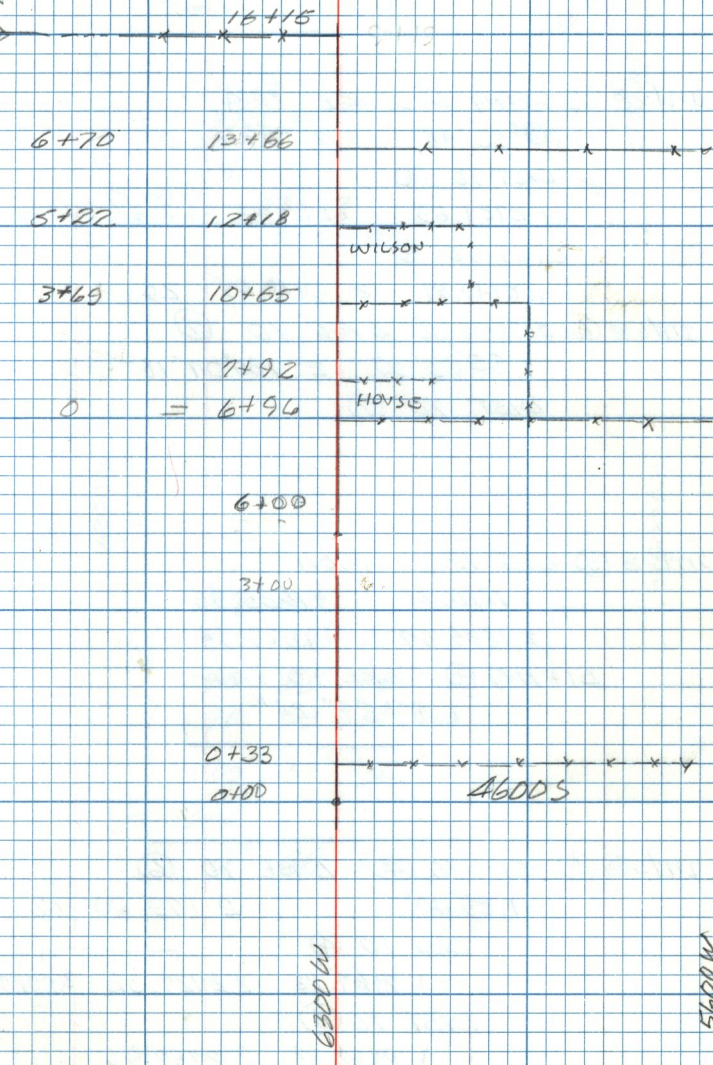

6300 W

5600 W