

ORDER # MC 82-51


MC-49-62

% Gary Laird

RULON P. PETERSON
PROP. # 08-050-0012

7/7/82 GEO & FIELD


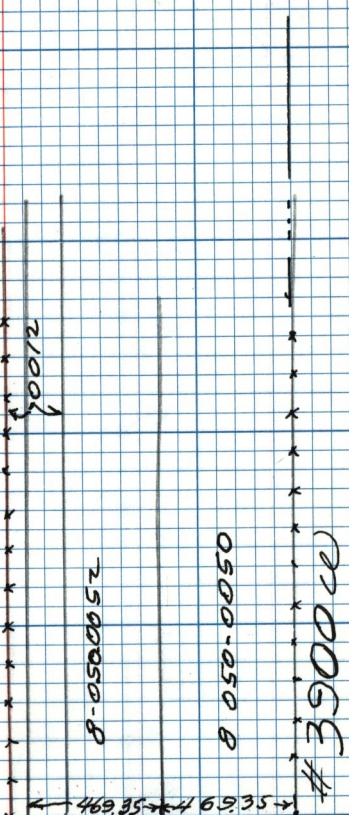

4800 SOUTH

(.84'
P. 10 H.)

2023.54

2622.70 DEPOSIS

+ 0.84' of 17.9' = (2640.7)
(REG. 1/4)