


6300W

2 RSPIKE

Sylvia



SPRINKLER LATHS

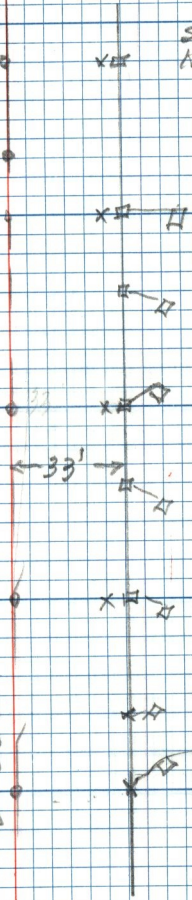

5100S

5900W