


14 AUG 1979

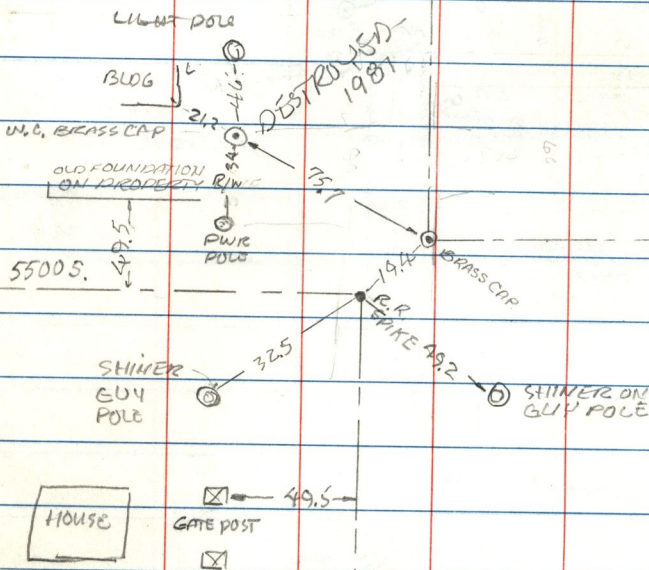

NOTE: ACCORDING
 TO RESIDENT WHOSE
 FATHER SET POST.
 SAID POSTS ARE DN
 ORIGINAL R/W

5500 W