16 AUG 79
J. CARUETH
R. PARKER
T. MURPHY

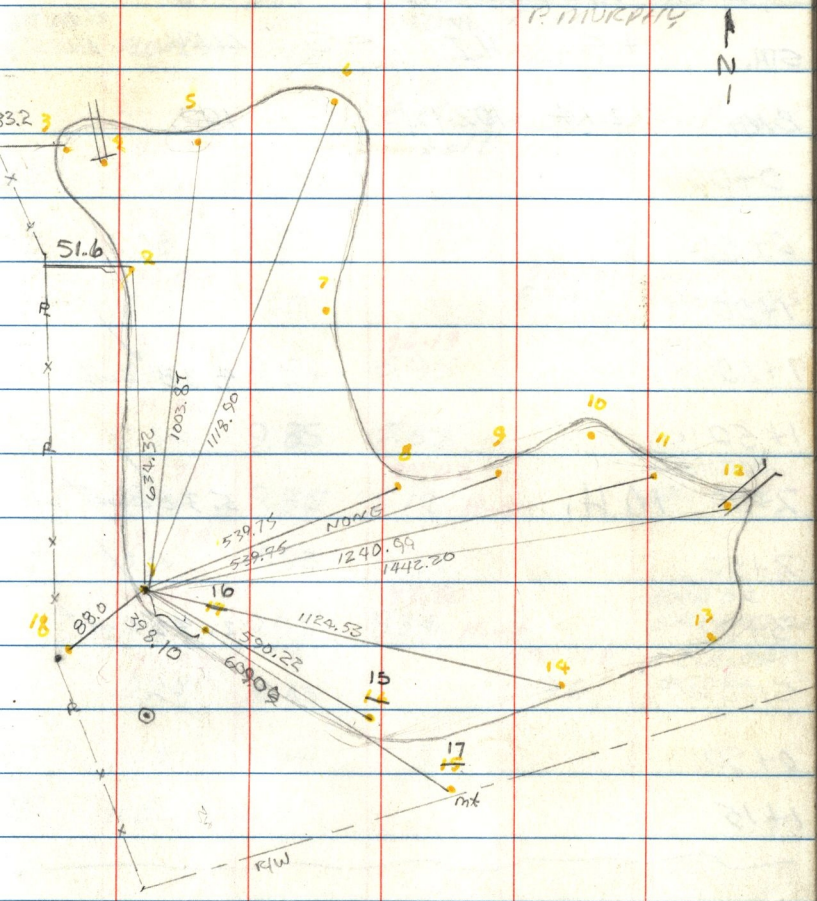

THIS POINT WAS PREVIOUSLY LEFT OUT