


299.90
 199.90
 499.80

499.80
 499.76

.04 DIFF.


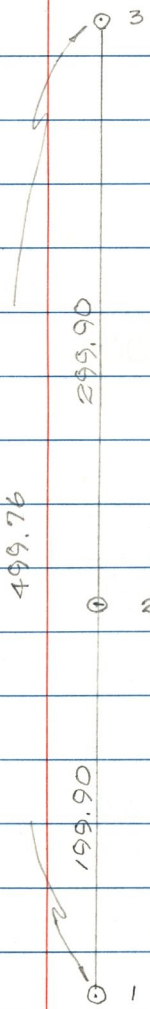

499.76